

PRELIMINARY DRAINAGE STUDY



NEWLAND SIERRA PDS 2014 MPA-14-018 VOLUME 4 – FEBRUARY 2017

Prepared For: Newland Sierra

Prepared By: Kenneth T. Kozlik

Job Number: 02660.002.02



APPENDIX C

CALTRANS AS-BUILTS

I-015-4(56)38

STATE OF CALIFORNIA
BUSINESS AND TRANSPORTATION AGENCY
DEPARTMENT OF TRANSPORTATION

INDEX OF SHEETS

Sheet No. 1	Title Sheet
" 2	Typical Cross Sections
" 3	Standard Plan List
" 4 - 19	Plans
" 20 - 25	Profiles
" 26 - 41	Drainage Layouts and Contour Grading
" 42 - 56	Drainage Profiles and Quantities
" 57 - 61	Drainage Layouts
" 62 - 71	Special Details
" 72 - 76	Drainage List
" 77	Miscellaneous Quantities and Details
" 78 - 81	Traffic Plans
" 82	Overhead Sign Format and Quantities
" 83 - 87	Lighting and Sign Illumination


BRIDGE STRUCTURE

" 88 - 96	Champane Boulevard Undercrossing (Br. No. 57-894 R/L)
" 1 - 94	Cross Sections


PROJECT PLANS FOR CONSTRUCTION ON
STATE HIGHWAY
IN SAN DIEGO COUNTY
NORTH OF ESCONDIDO FROM 1.5 MILES NORTH
OF DEER SPRINGS ROAD TO 0.5 MILE SOUTH
OF GOPHER CANYON ROAD
To be supplemented by Standard Plans dated March 1977

BEGINNING OF MAJOR CONSTRUCTION
STA. 1825+00 P.M. R38.1

END OF MAJOR CONSTRUCTION
STA. 1946+00 P.M. R40.4

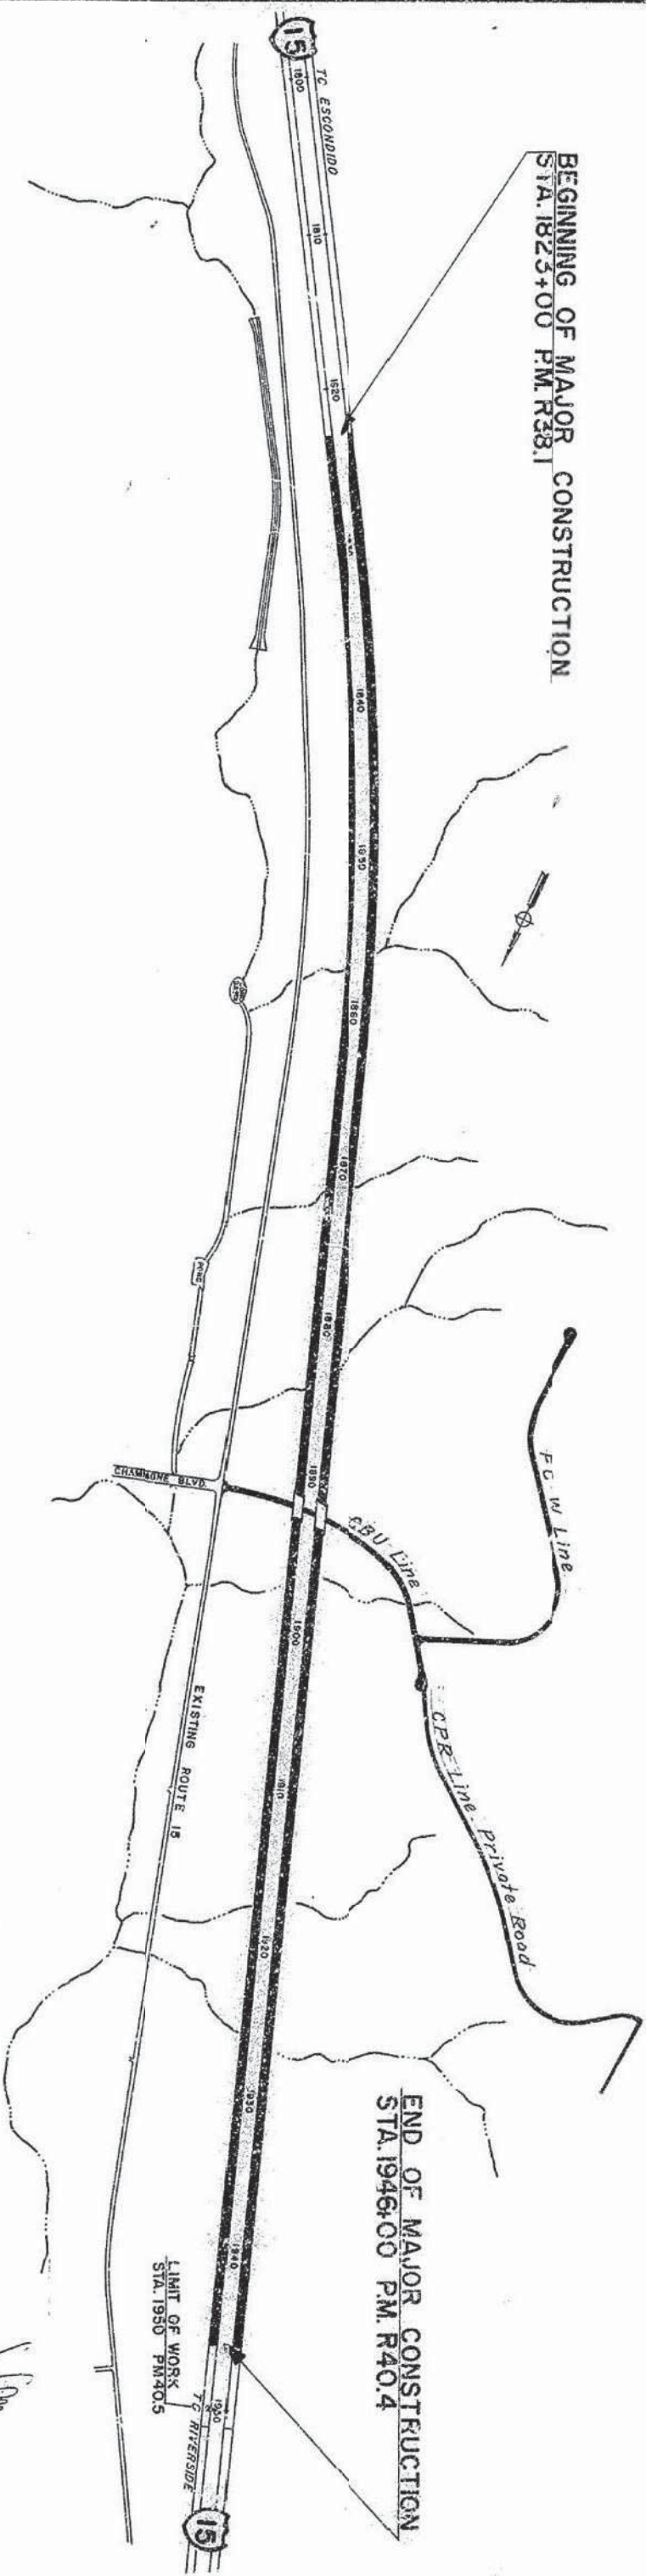

SCALE IN FEET
0 1000 2000 3000
Length of Work = 2.3 miles
Length of Major Construction = 2.3 miles

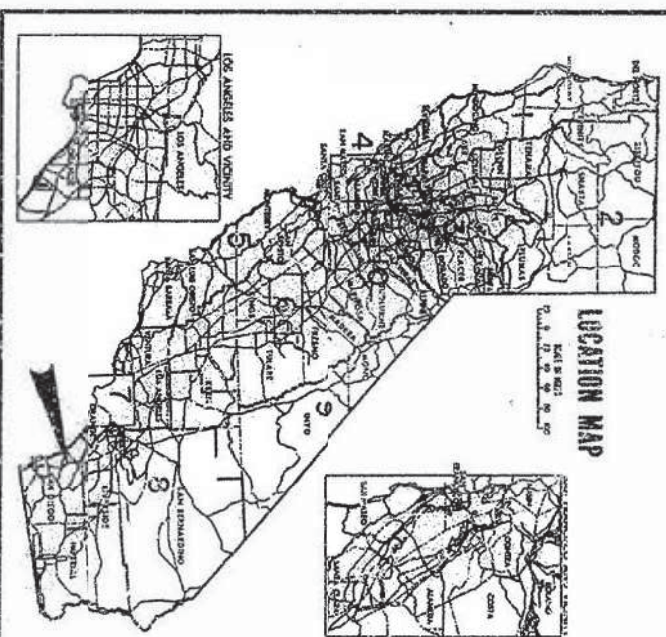


DIST.	COUNTY	ROUTE	POST MILE - TOTAL PROJECT	POST MILE - THIS SHEET
11	SD	15	R38.1/R40.4	1 96

"AS BUILT"
CONTRACT 11-095054
YEAR COMPLETED 5-30-80
Approved JULY 10, 1978
District Director of Transportation
Registered Civil Engineer No. 5702
Contract No. 11-095054
11203-095051




NO.	DATE	REVISION	BY	DATE
11	SD	15	R381/R404	27

PROJECT ENGINEER
 DATE APPROVED July 10, 1978
 REGISTERED CIVIL ENGINEER
 No. 11725

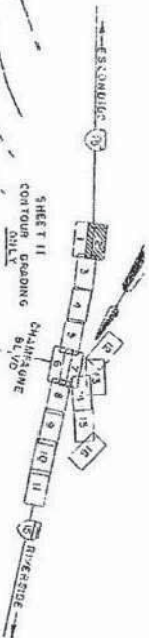


COUNTY OF SAN DIEGO

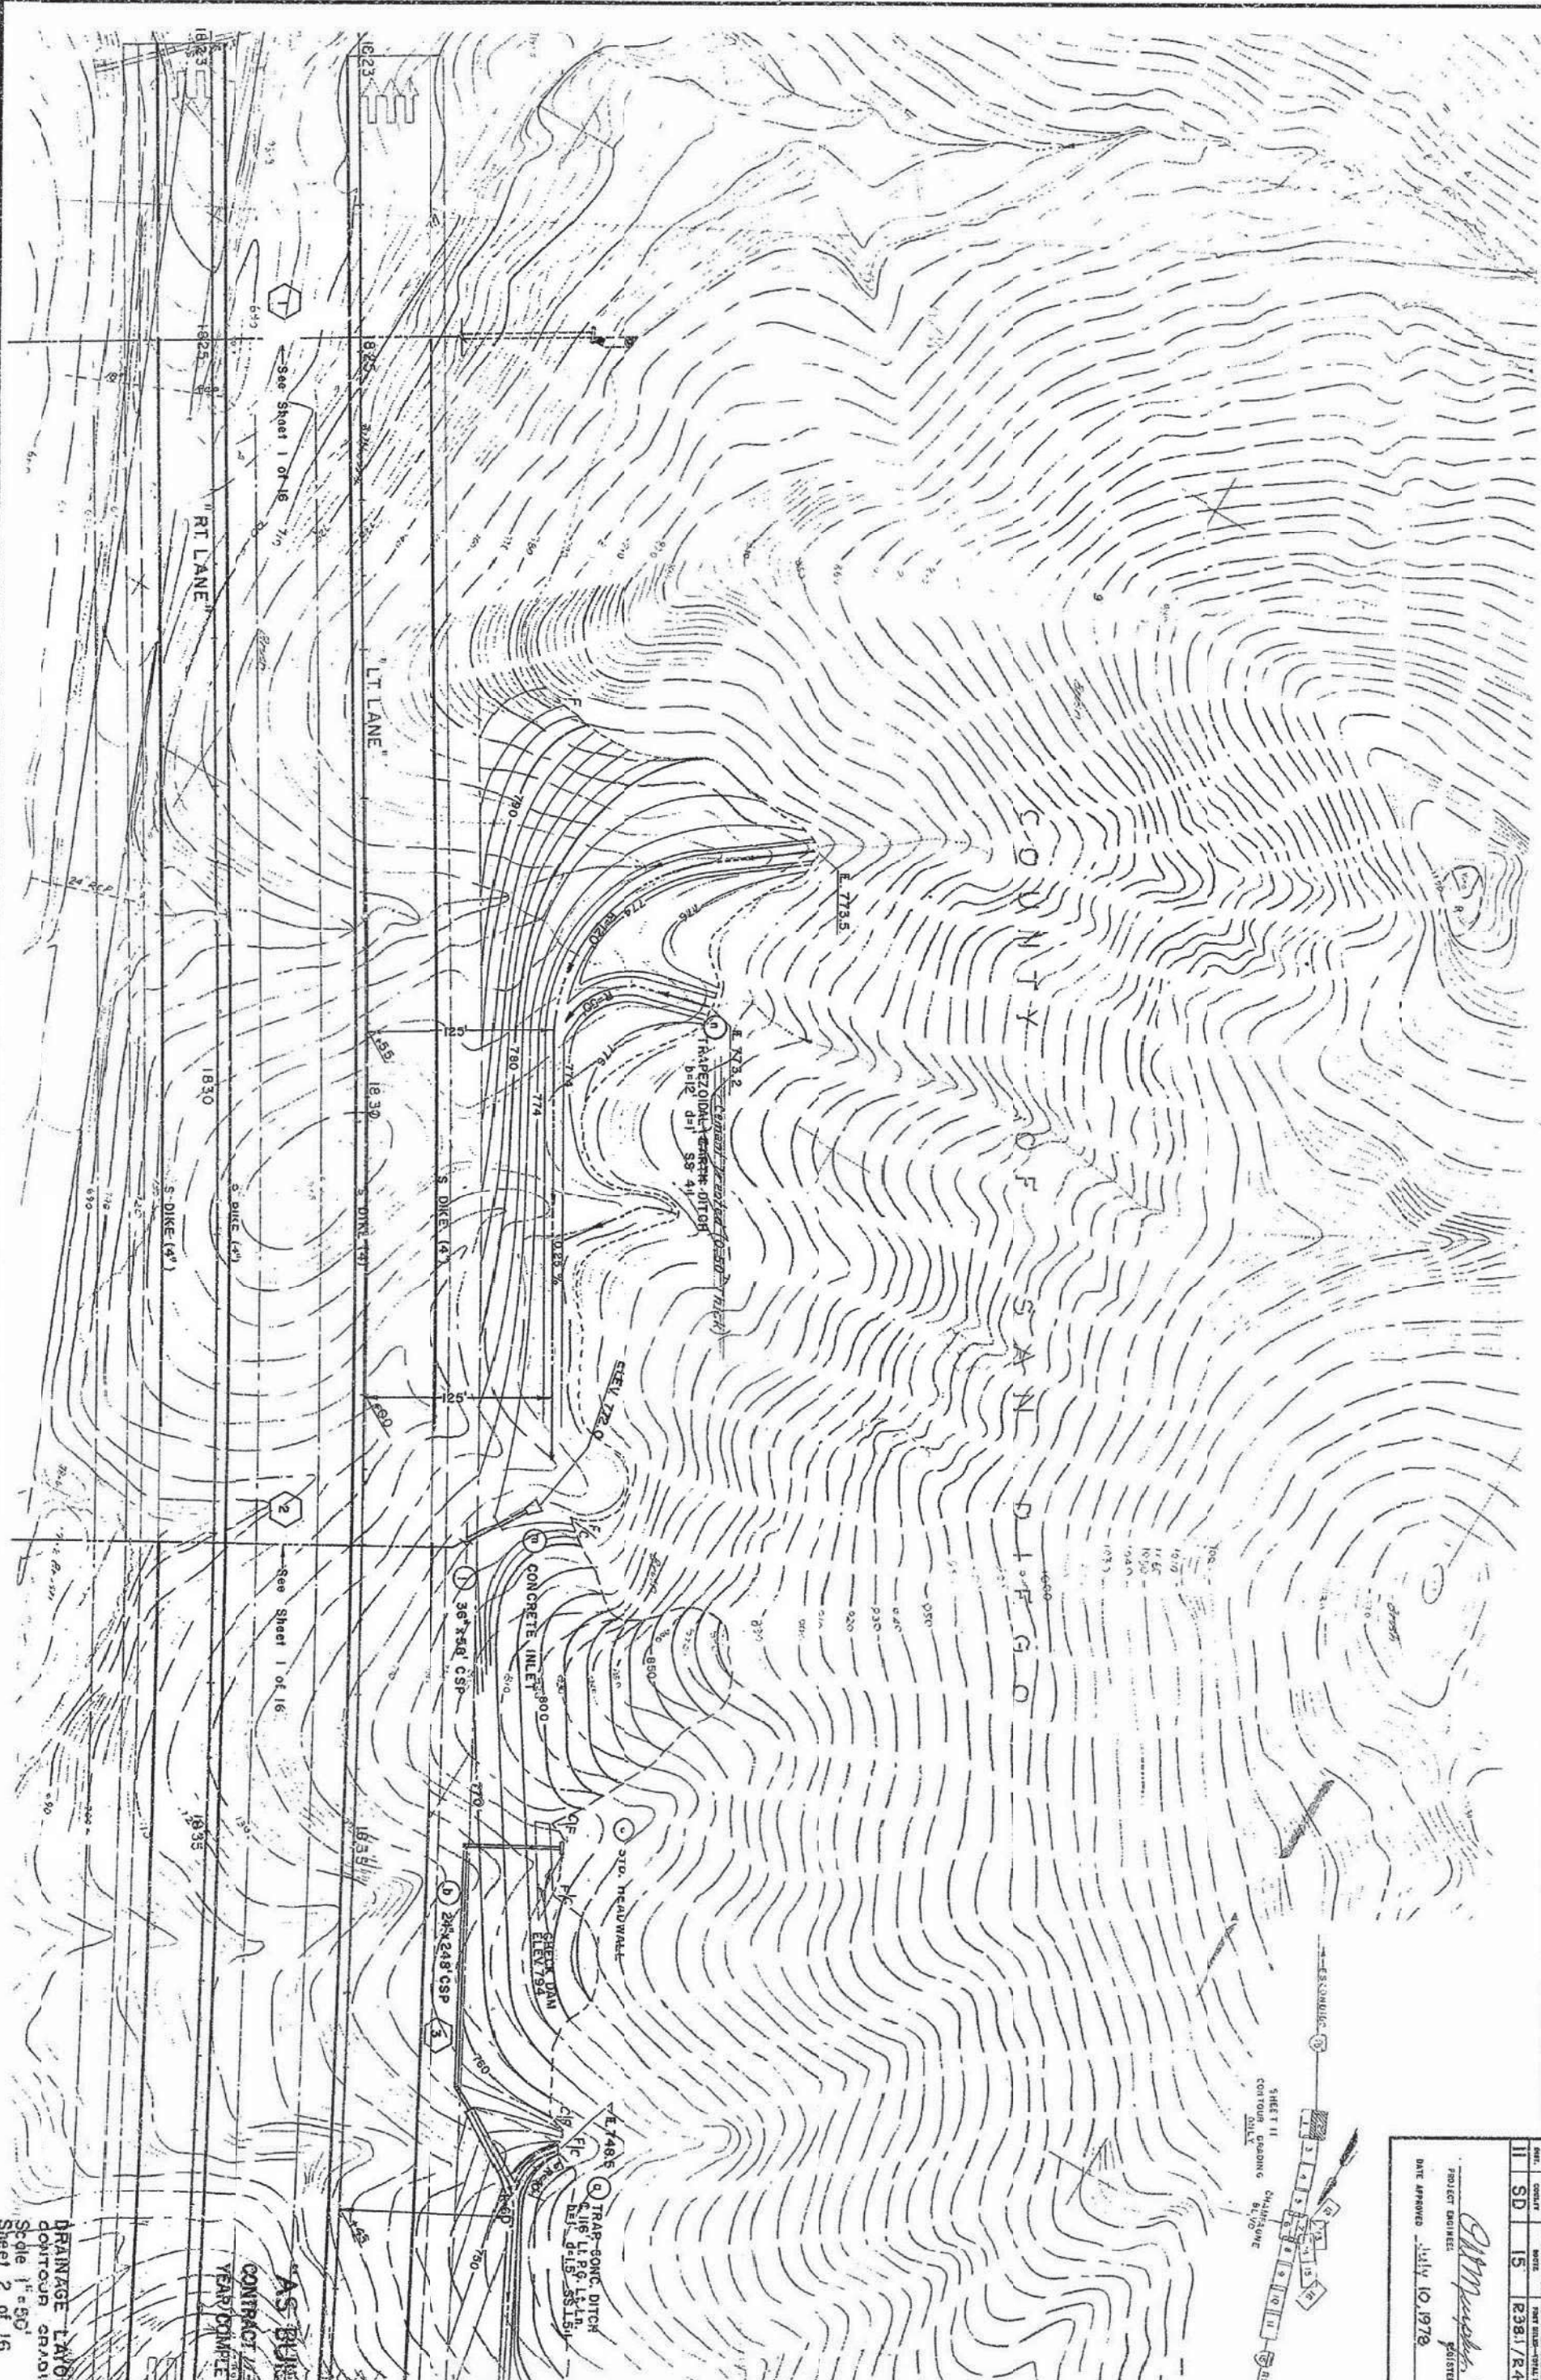

Project Engineer	Date	Design Engineer	Date	Approved Recommended By	Date
P. D. Murphy		J. O. Gray		J. O. Grabberger	

DRAINAGE LAYOUTS AND
 CONTOUR DRAWING PLAN
 Scale 1"=50'
 Sheet 2 of 16

AS BUILT
 CONTRACT 11-0955-1
 YEAR COMPLETED 1970-71

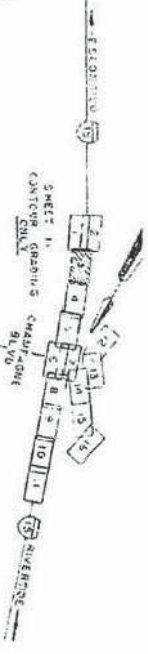

NO.	CONTRACT	DATE	REVISION	BY	DATE
11	SD	15	R38.1/R40.4	26	9/7

PROJECT ENGINEER
DATE APPROVED July 10, 1978
REGISTERED CIVIL ENGINEER
NO. 11723



AS BUILT
CONTRACT 11-222027
YEAR COMPLETED 5-30-80
DRAINAGE LAYOUTS AND
CONTOUR GRADING PLAN
Scale 1"=50'
Sheet 3 of 16

Project Engineer	Design Engineer	Approved Recommended By	Date
P. D. Murphy	L. D. Gray	L. D. Gray	

