Acreage Within
Biological Open Space

~~1.04~~ SS – Sagebrush Scrub (Big) 35210

~~1.1~~ NNG – Non-native Grassland 42200

~~0.73~~ CLOW – Coast Live Oak Woodland (Dense) 71162

~~7.99~~ NMC – Northern Mixed Chaparral 37110

Proposed Biological Open Space

1" = 100'

TPM 20756 – Arellano 3-Lot Subdivision

ER 03-19-011

July 24, 2008, Valerie Walsh, Staff Biologist, DPLU

Proposed Biological Open Space Easement

Proposed Limited Building Zone Easement

Permanent Fencing

Permanent Signs Every 100 feet

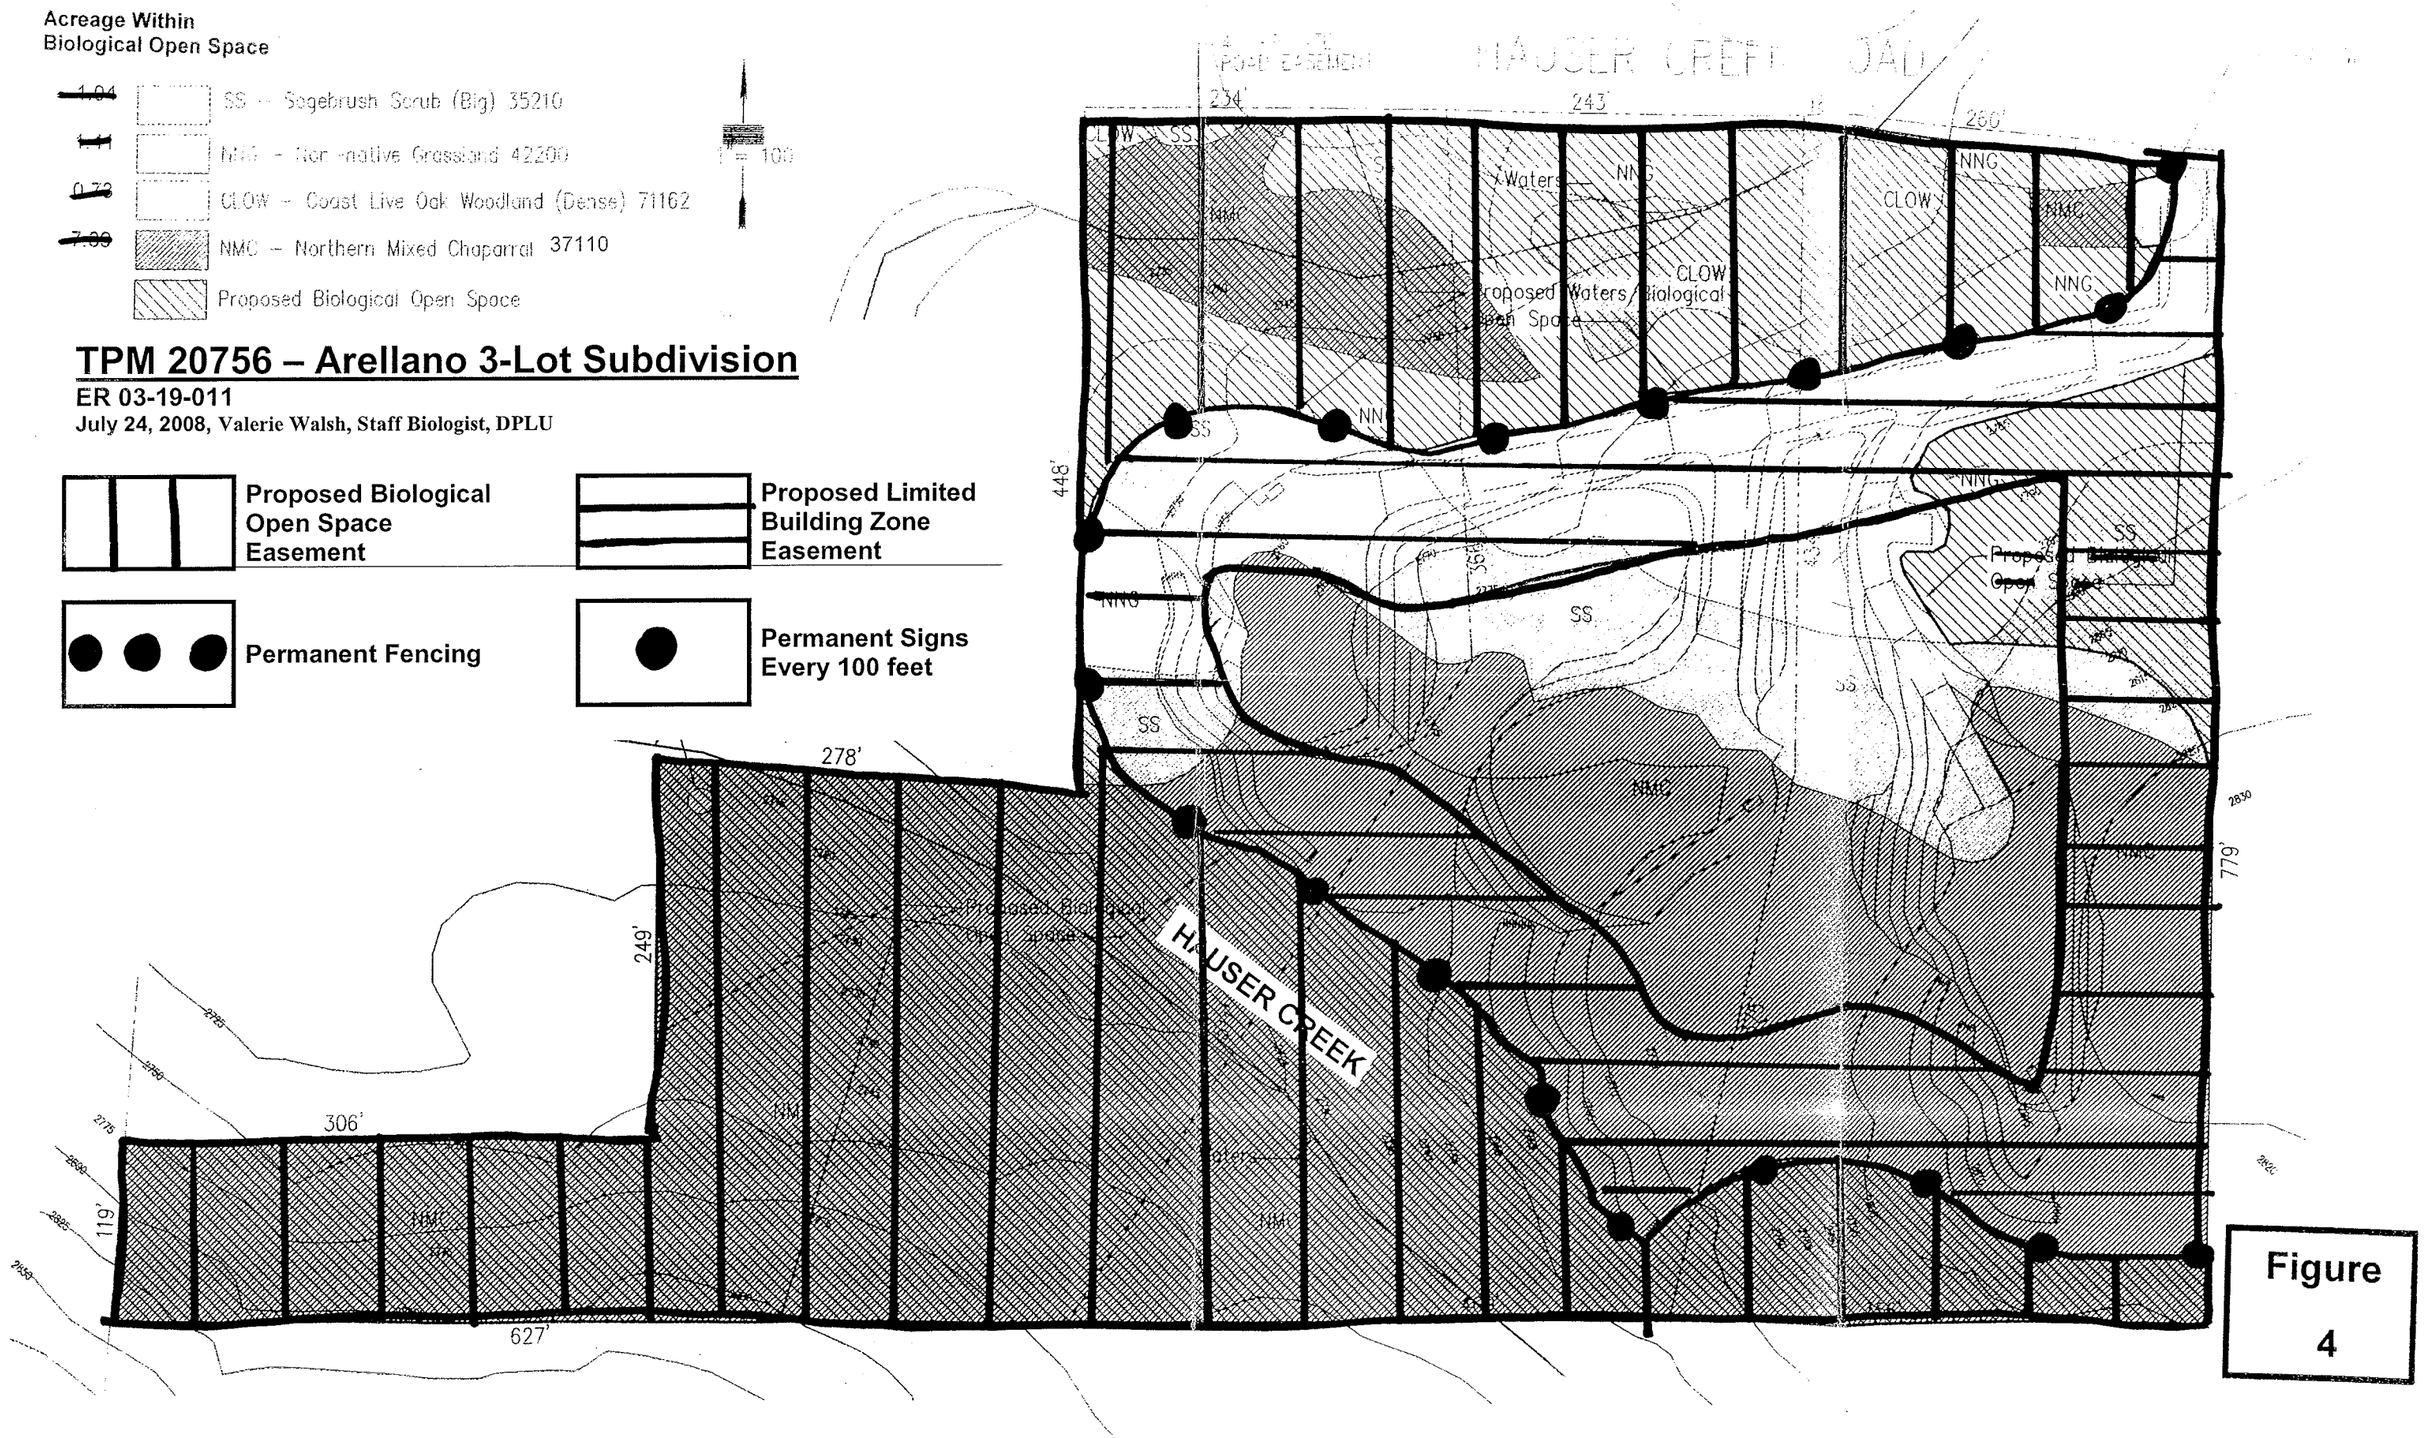

Figure 4